

**SCDHEC OFFICE OF OCEAN AND COASTAL RESOURCE MANAGEMENT
PERMIT APPLICATION PUBLIC NOTICE**

June 27, 2008

Permit Number: OCRM-08-526-S
Permit ID: 63614

The SCDHEC Office of Ocean and Coastal Resource Management has received an application for a permit for the alteration of a critical area. This application was submitted pursuant to the Coastal Zone Management Act (Act 123) of the 1977 South Carolina General Assembly. The application, in brief, is described as follows:

APPLICANT: Calvin Mason
c/o Southeastern Marine Construction & Supply
PO Box 1986
Murrells Inlet SC 29576

LOCATION: On and adjacent to Murrells Inlet Creek at 2267 Oyster Cove Cir, Garden City Beach, Georgetown County, South Carolina.
TMS#: 41-0130-020-66-00.

WORK: The work, as proposed and shown on the attached drawings, consists of installing a replacement bulkhead. Specifically the applicant seeks to construct a 106' vinyl bulkhead 18" channelward of an existing concrete bulkhead. The preexisting dock and floating docks will be removed and then replaced when work is completed. The purpose of the proposed bulkhead is for erosion control.

This public notice is being distributed to all known interested persons and agencies to assist in developing facts on which a decision by OCRM can be based. Comments concerning the proposed work should be submitted in writing, setting forth sufficient detail to furnish a clear understanding of the reasons for support or opposition.


The decision to issue or deny a permit will be based on the individual merits of the application, the policies specified in the South Carolina Coastal Zone Management Act, and the considerations outlined in the State of South Carolina Coastal Zone Management Program. Interested parties who wish to be notified of final permit action must notify OCRM in writing of this request.

To assure review by OCRM, comments regarding this application must be received by OCRM on or before July 12, 2008. For further information please contact the project manager for this activity, Christopher Stout at 843-238-4528.

PLEASE REPLY TO:

 
SCDHEC OFFICE OF OCEAN AND COASTAL RESOURCE MANAGEMENT
927 Shine Avenue
Myrtle Beach, South Carolina 29577

Please refer to P/N# OCRM-08-526-S



Christopher Stout, Wetland Project Manager

CURVE	RADIUS	ARC LENGTH	CHORD LENGTH	CHORD BEARING	DELTA ANGLE
C1	60.00'	41.00'	40.21'	S85°33'08"E	19°08'19"



**SC GRID BEARINGS
HORIZONTAL DISTANCES**

AVG. HIGH TIDE IS APPROXIMATELY 3.8' -
AVG. LOW TIDE IS APPROXIMATELY -1.0'

REF. PLAT. PLAT OF LOT 43 INLET POINT FOR WANDA MASON
BY J. LUCKY SANDERS, RLS DATED JANUARY 4, 2001


I hereby state that to the best of my knowledge, information, and belief, the survey shown hereon was made in accordance with the requirements of the Minimum Standards Manual for the Practice of Land Surveying in South Carolina, and meets or exceeds the requirements for a Class B Survey as specified therein. Also there are no visible encroachments or projections.

TMS # 41-0130-020-66-00

Craig Mercer Thomas
Craig Mercer Thomas, P.L.S. S.C. # 11073

REVISED 6/9/08

DYSTER COVE CIRCLE

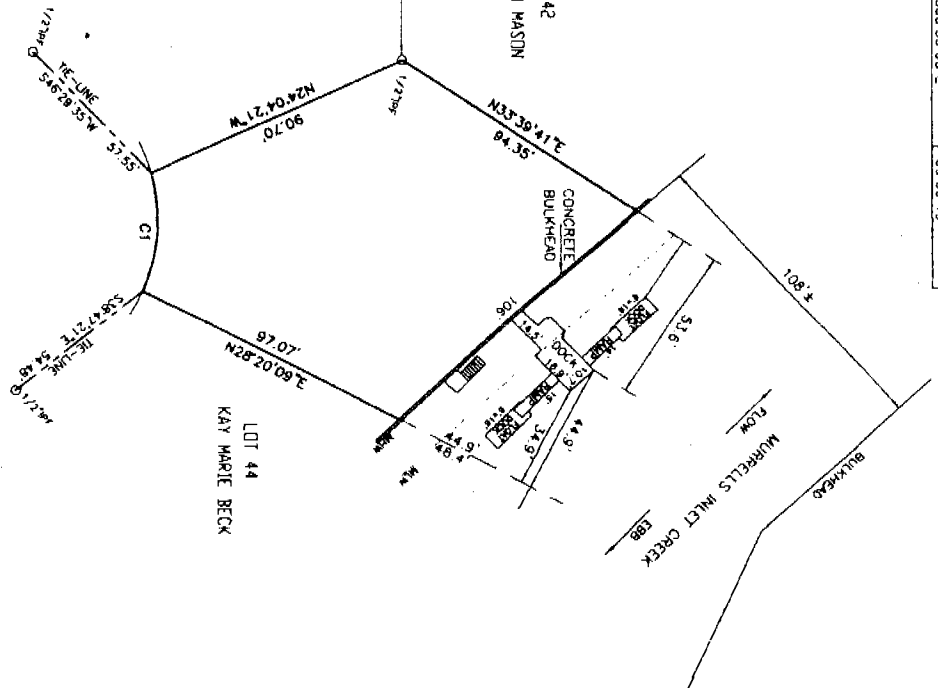

AS-BUILT SURVEY
of
**EXISTING WALKWAY,
DOCK and BULKHEAD**
LOT 43 INLET POINT
GARDEN CITY
GEORGETOWN COUNTY, S.C.
SURVEYED FOR

**CALVIN and WANDA
MASON**

NOT TO SCALE


Waccamaw Land Surveyors, Inc.
640F Hwy 17 South
Surfside Beach, S.C. 29575

MAY 28, 2008
SCALE: 1" = 40'



OCRM-08-526-5

CURVE	RADIUS	ARC LENGTH	CHORD LENGTH	CHORD BEARING	DELTA ANGLE
C1	50.00	41.10	40.71	S85°33'08"E	39°08'18"

 

SC GRID BEARINGS HORIZONTAL DISTANCES


AVG HIGH TIDE IS APPROXIMATELY 38'
AVG LOW TIDE IS APPROXIMATELY 10'

REF PLAT A-1 OF LOT 43 INLET POINT UNDER WAY
BY J. LUCY SMITH, R.S. MEASUREMENT 1, 2001

I hereby state that to the best of my knowledge, information and belief, the survey from herein was made in accordance with the rules and regulations of the State of South Carolina, and that I am a duly Licensed Professional Surveyor in South Carolina, and that I am duly qualified to perform the services herein.

THIS IS 41-DIGIT-020-66-00

Craig Mercer Thomas
Craig Mercer Thomas, PLS. SC. # 11073

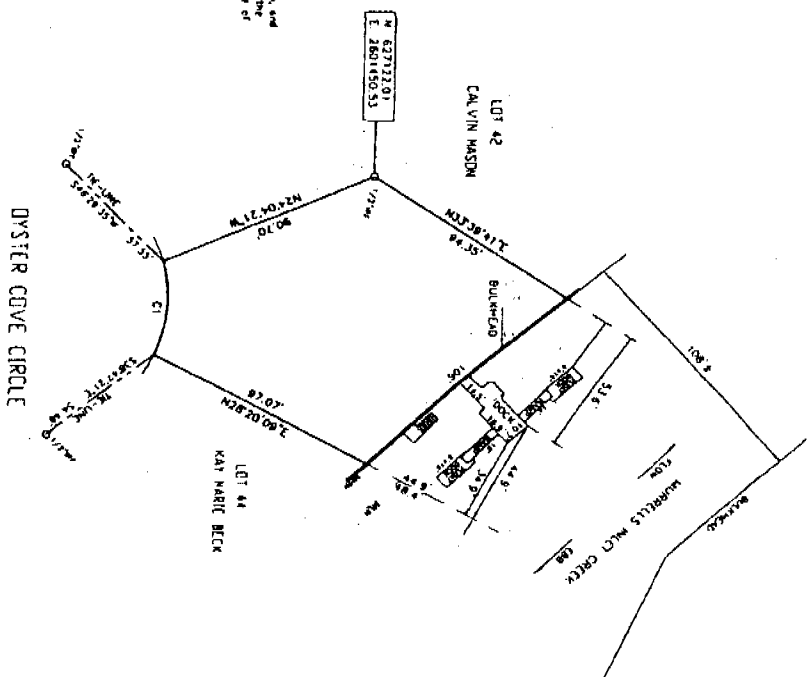

REVISED 6/9/08


DYSTER COVE CIRCLE

Waccamaw Land Surveyors, Inc.
640F Hwy 17 South
Surfside Beach, S.C. 29575
MAY 28, 2008
SCALE: 1" = 40'

NOT TO SCALE

CALVIN and WANDA
MASON

ACTIVITY
REPLACEMENT BULKHEAD
LOT 43 INLET POINT
GARDEN CITY
GEORGETOWN COUNTY, SC.
SURVEYED FOR

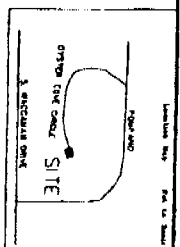

OCRM-08-526-S

POWELL
OYSTER COVE DRAG
5. MACCAW DRIVE
SITE

LOT 43 INLET POINT

GARDEN CITY
GEORGETOWN COUNTY, S.C.
SURVEYED FOR

CALVIN and WANDA
MASON


Waccamaw Land Surveyors, Inc.
640F Hwy 17 South
Surfside Beach, S.C. 29575
MAY 28, 2006


MAY 28, 2008

NOT TO SCALE

REVISED 8/8/06

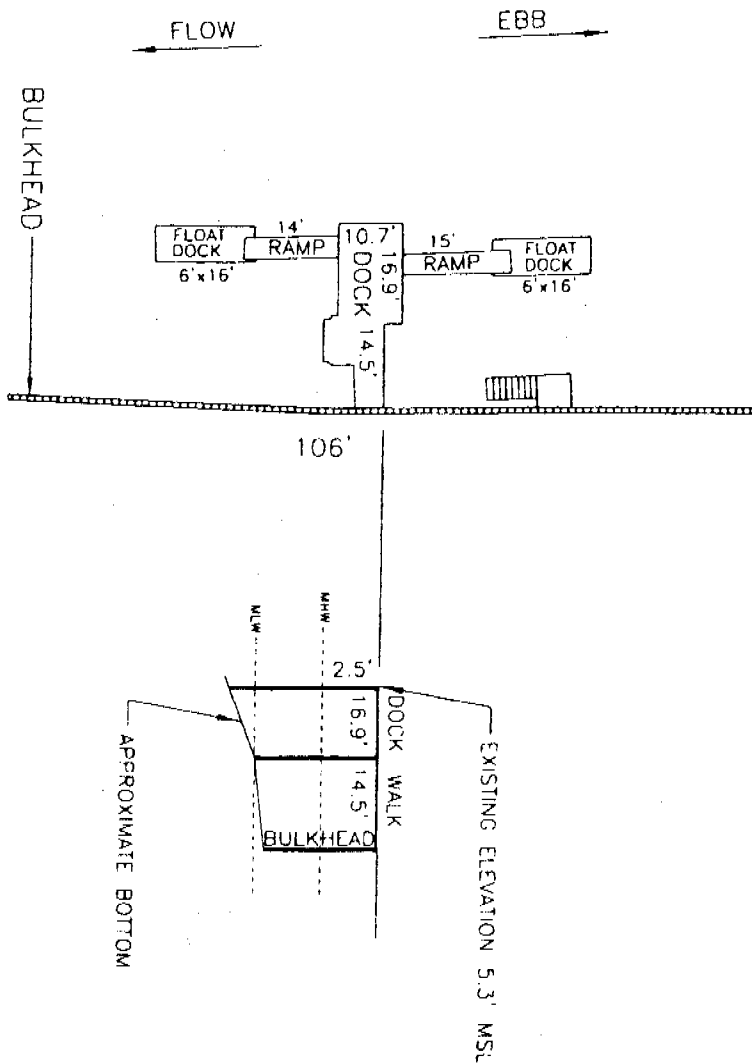

Ernest Mercer Thomas
Ernest Mercer Thomas, P.L.S. S.C. # 11073

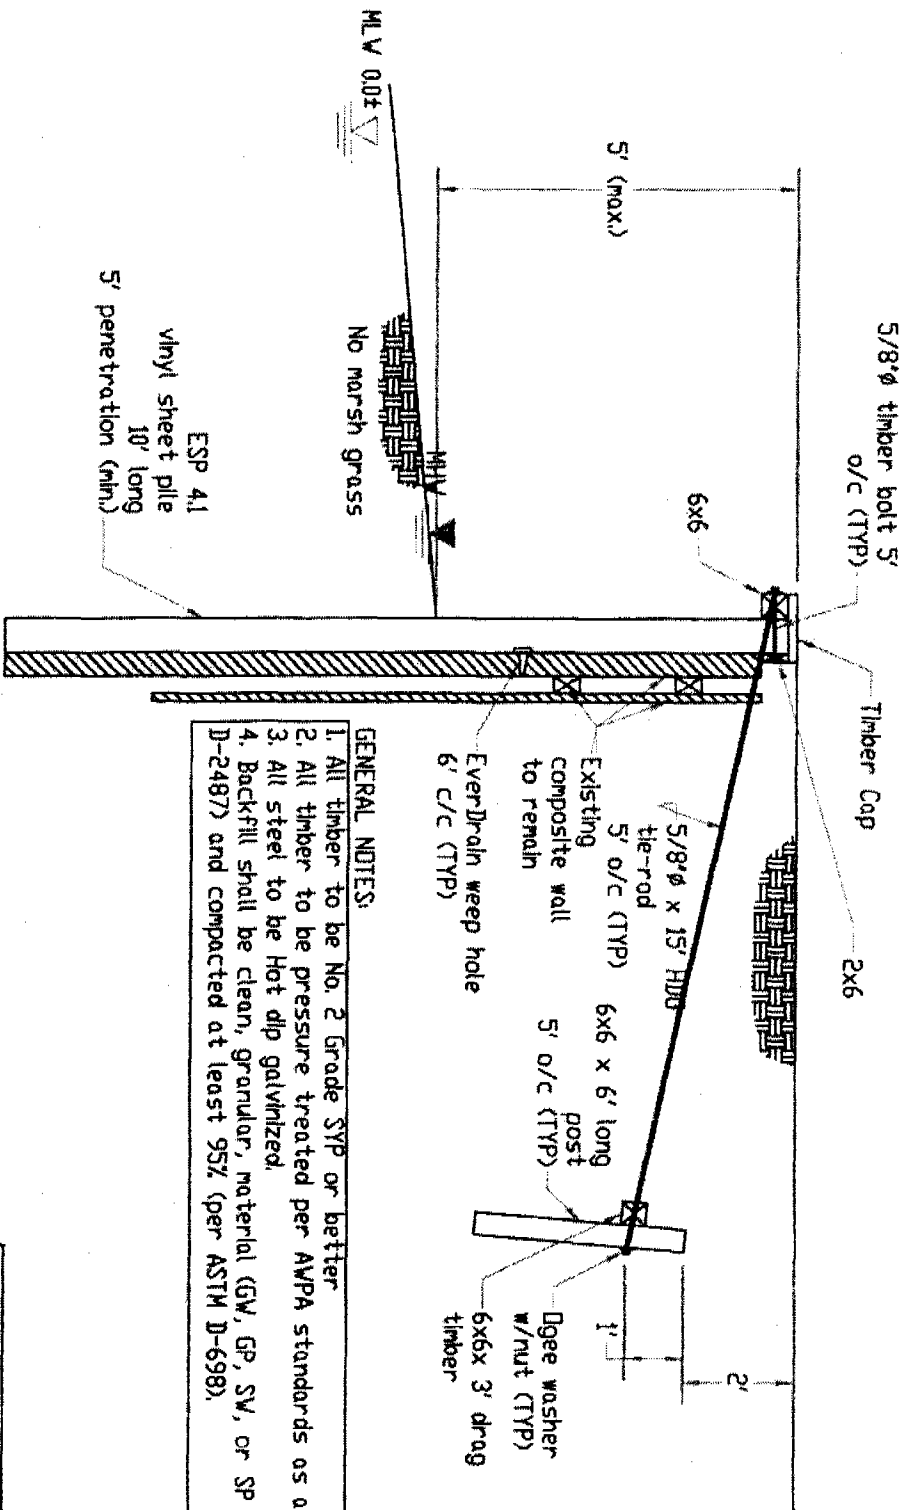



- GENERAL NOTES:**
1. All timber to be No. 2 Grade SYP or better
 2. All timber to be pressure treated per AWPA standards as applicable.
 3. All steel to be Hot dip galvanized.
 4. Backfill shall be clean, granular, material (GW, GP, SW, or SP per ASTM D-2487) and compacted at least 95% (per ASTM D-698).

SECTION A-A (Timber Deadman Option) Scale: As noted

APPLICANT: Calvin Mason ACTIVITY: Bulkhead Replacement P/N #: CRM-08-526-S		ADJACENT PROPERTY OWNERS: 1. Gregory Pilkenton 2. Kay Marie Beck		 Everlast Synthetic Products, LLC 1000 WYNGATE PKWY, S-100 WOODSTOCK, GA 30189 (678)-388-7781	 CARL A. HATTEN FOR PERMITTING ONLY - NOT FOR CONSTRUCTION
LOCATION: 2267 Dyster Cove Cir. Garden City, SC 29576		SCALE: NTS SHEET: 7 OF 7			
COUNTY: Georgetown DATE: 6/10/08					




Results 1-12 of about 88 for oyster cove near
Garden City, Uninc Horry County, S
Carolina

Get Google Maps on your phone
Text the word "GMAPS" to 466453



- A. 2215 OYSTER COVE CIRCLE, \$1,495,000
- B. Ocean Reef
7100 N Ocean Blvd, Myrtle Beach, SC
(888) 322-6411 - ★★★★★
- C. Compass Cove Ocean Front Resort
2311 South Ocean Blvd, Myrtle Beach, SC
(800) 331-0934 - ★★★★★
- D. Oyster Bay Golf Links: Reservations
1500 Legends Rd, Myrtle Beach, SC
(843) 236-9318
- E. Dirty Don's Oyster Bar & Grill
408 21st Ave N, Myrtle Beach, SC
(843) 448-4881 - 6 reviews
- F. Pirates Cove Lounge Inc
205 Main St, North Myrtle Bch, SC
(843) 249-8942
- G. Patricia Suites Resort Hotels
6804 N Ocean Blvd, Myrtle Beach, SC
(843) 449-1415
- H. Premier Resorts @ Barefoot Resort & Golf
4980 Barefoot Resort Bridge Rd, N. Myrtle Bch, SC
(843) 390-7900 - ★★★★★
- I. Waterway Hills Golf Course
9731 N Kings Hwy, Myrtle Beach, SC
(843) 449-6489 - 1 review
- J. The Carolina Opry and Good Vibrations
8901-A Business 17 North, Myrtle Beach, SC
(800) 843-6779 - ★★★★★

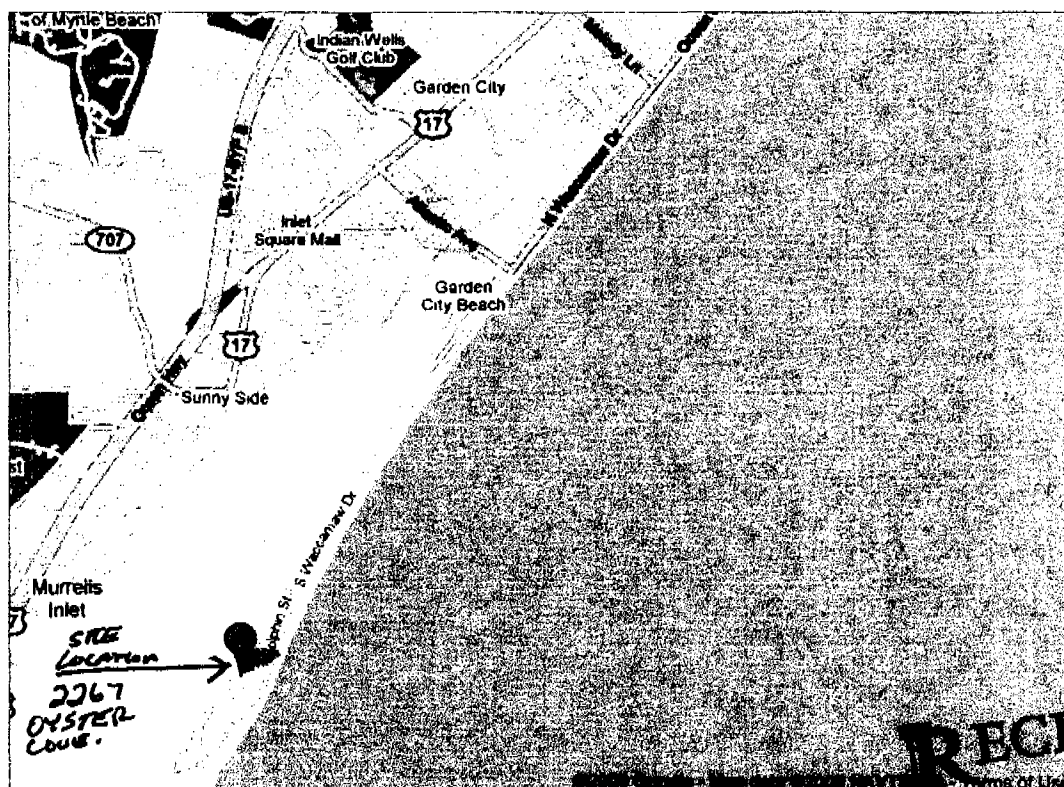

OCRM-08-526-S

RECEIVED

JUN 4 2008
DEPT. OF CRIMINAL JUSTICE
MYRTLE BEACH OFFICE